




BROADWAY WEST


Suite 1700

As-Built

2,171 Sq. Ft.

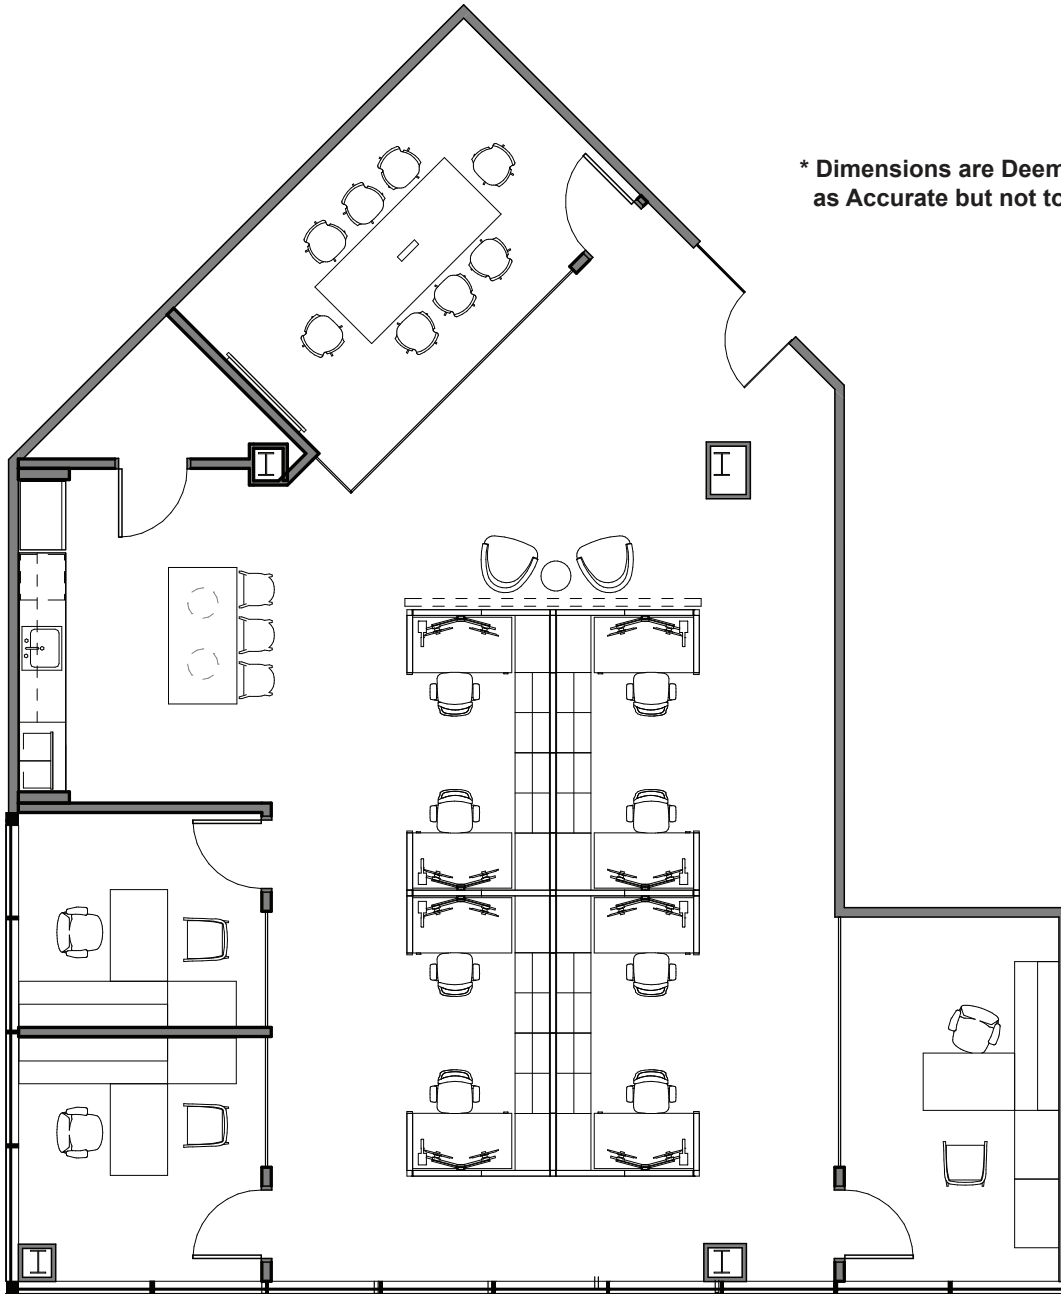

* Dimensions are Deemed
as Accurate but not to Scale

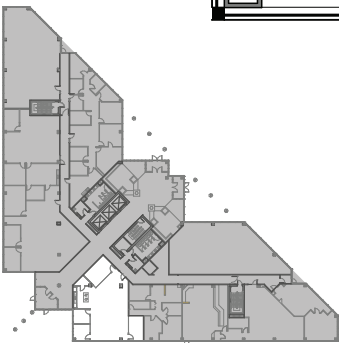

ALTUS



JLL®